



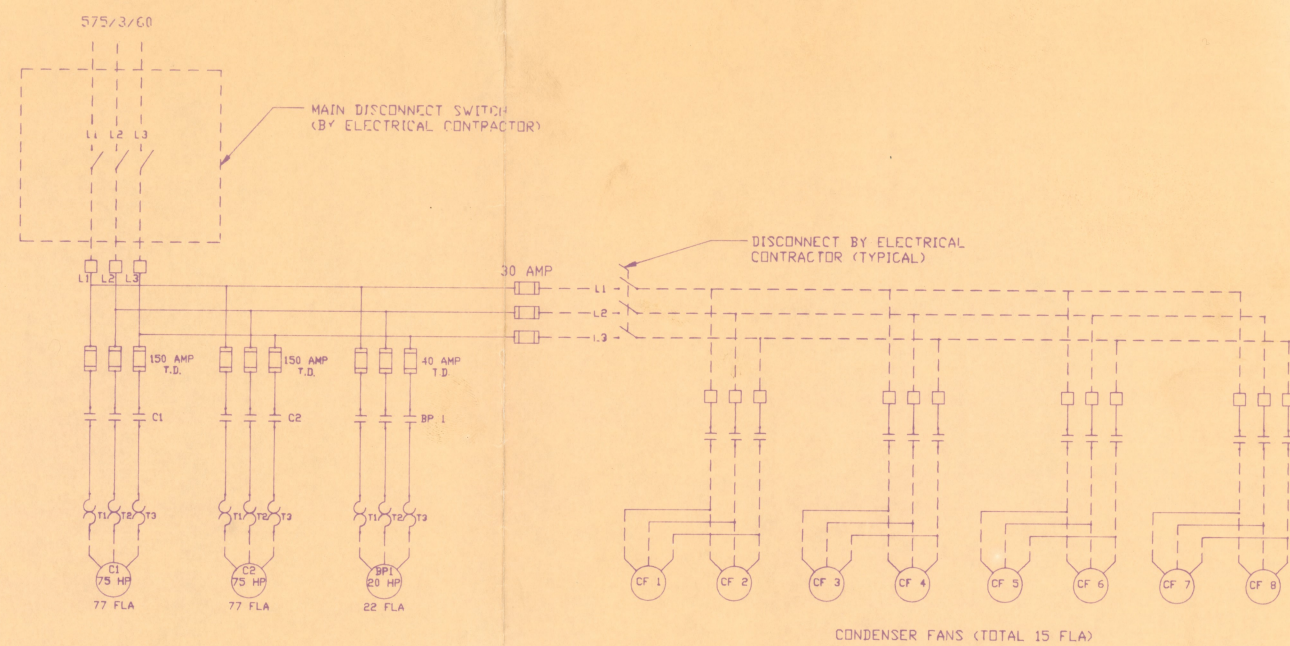


POWER WIRING

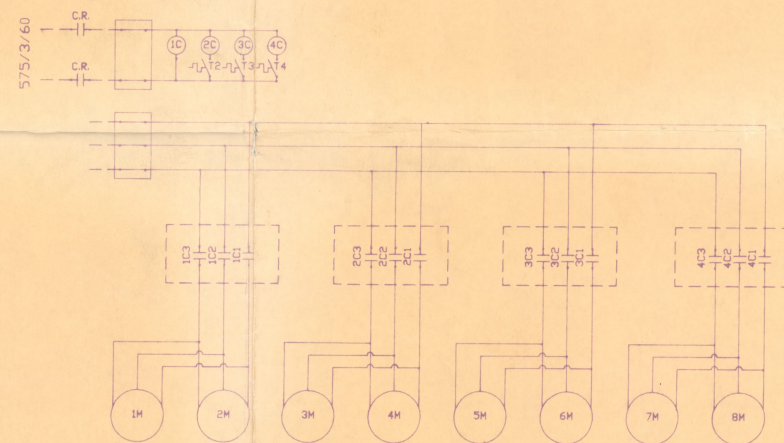

DDC 110 CONDENSER ELECTRICAL CONTROL PANEL WIRING

LEGEND

- | | |
|------------------------------|---------------------------------------|
| C - COMPRESSOR CONTACTOR | LP - LOW PRESSURE SWITCH |
| CF - CONDENSER FAN CONTACTOR | HP - HIGH PRESSURE SWITCH |
| O/L - OVERLOAD | HOT HIGH DISCHARGE THERMOSTAT |
| BP - BRINE PUMP CONTACTOR | OFS - OIL FAILURE SWITCH |
| TD - TIME DELAY RELAY | RAHP - REVERSE ACTING HIGH PRESS. SW. |
| R - RELAY | HM - ELAPSED TIME METER |
| □ - TERMINAL BLOCK | CR - CONDENSER RELAY |

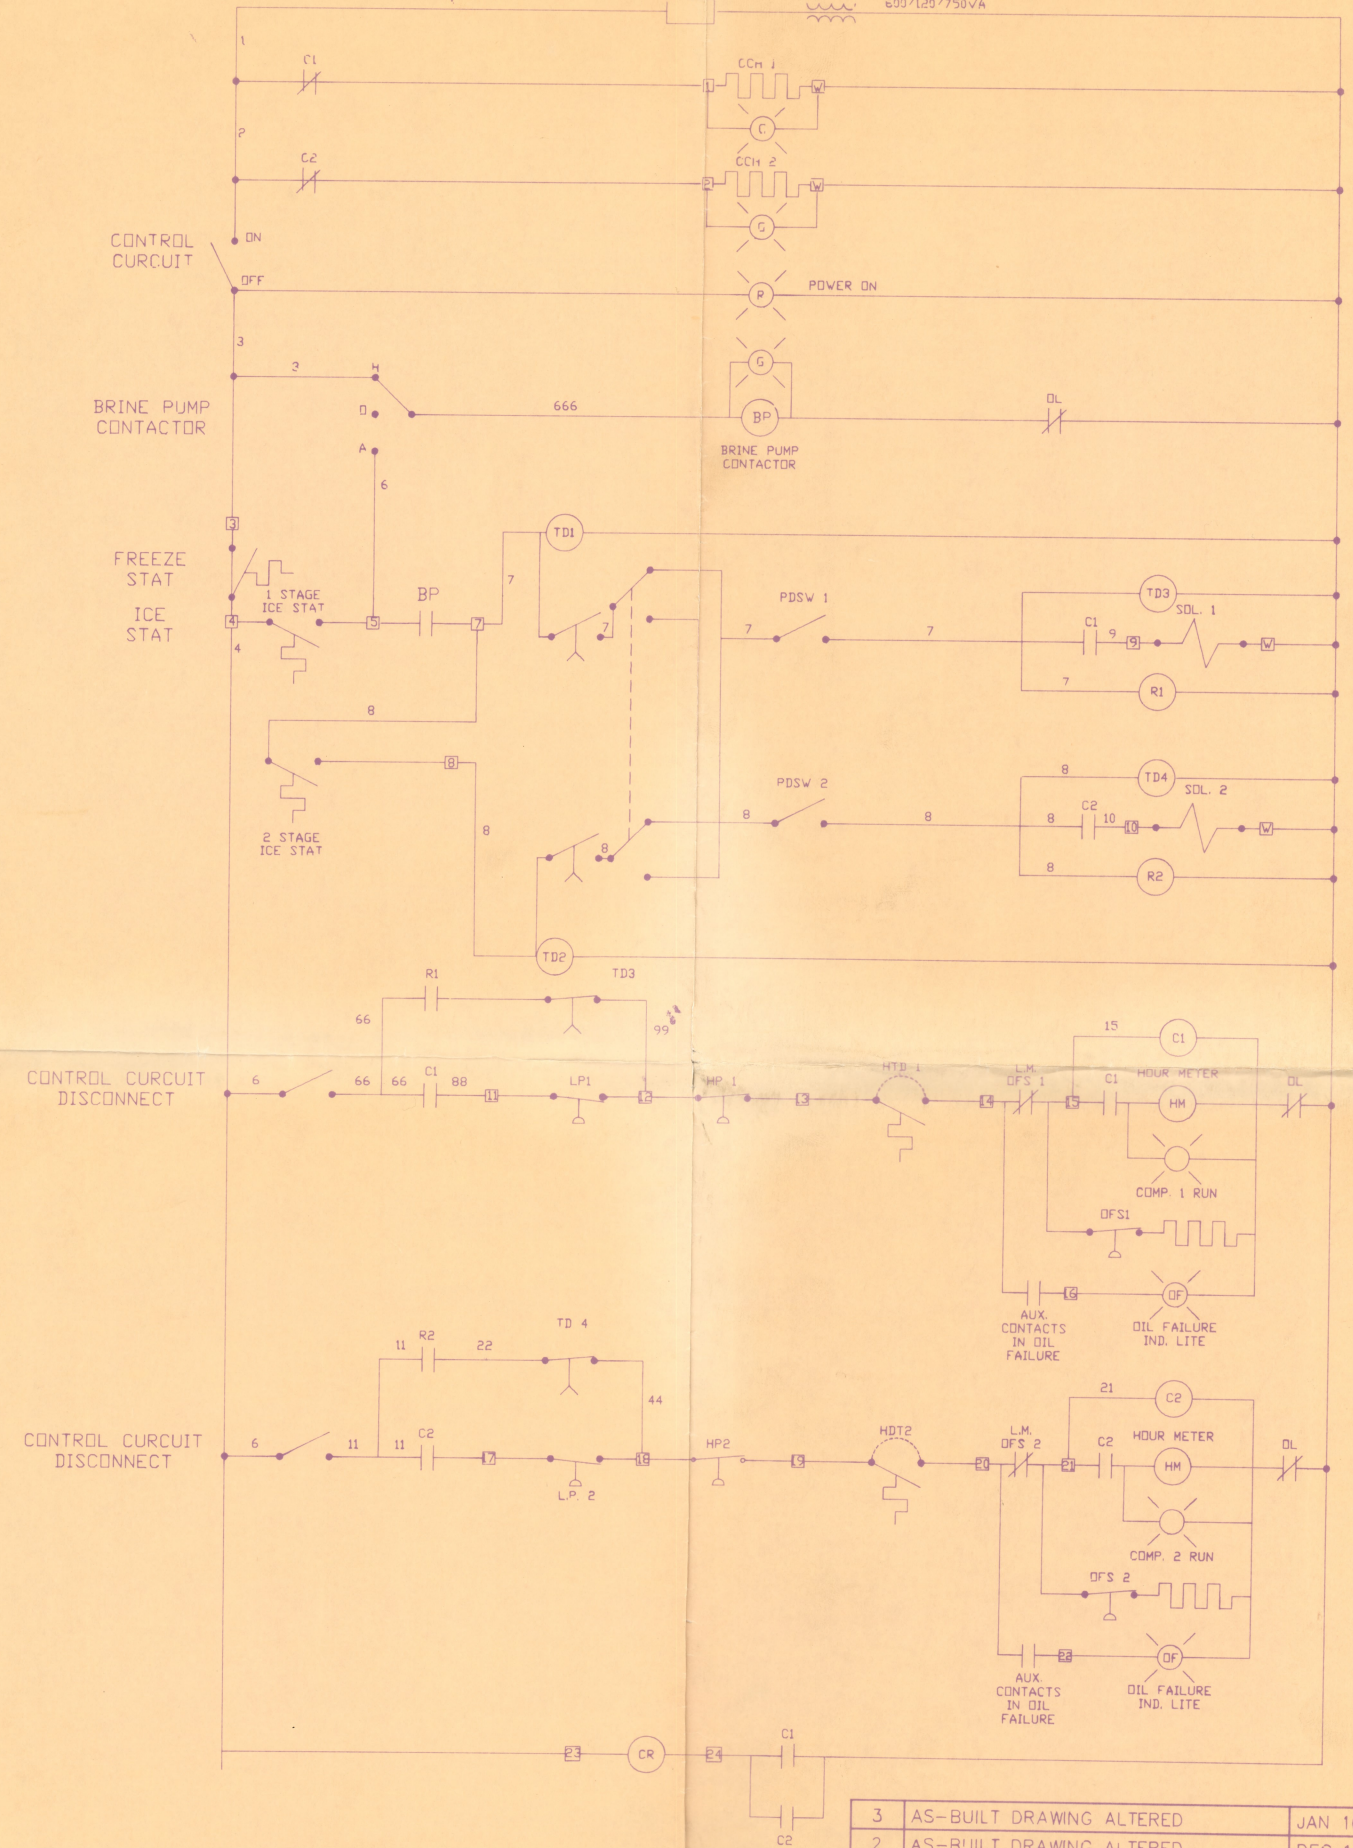

CONTROL WIRING

3	AS-BUILT DRAWING ALTERED	JAN 16,90	G.L.
2	AS-BUILT DRAWING ALTERED	DEC 11,89	
1	AS-BUILT DRAWING	NOV 28,89	
REV. #	REVISION	DATE	BY

Fleming Pedlar Ltd.
 HEAD OFFICE: 565 MUNROE AVE., WINNIPEG, MB, R2K 1H7
 1-204-667-7863

AIR CONDITIONING
 STORE FIXTURES
 REFRIGERATION
 HEATING

DRWN: G.L.
 CHKD:

AS-BUILT ELECTRICAL
 FOR
 DON ROSS ARENA

SCALE:
 N/A